




MCC-2
M203
TR-2 CIP

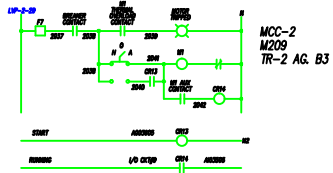


MCC-2
M209
TR-2 AG. B3

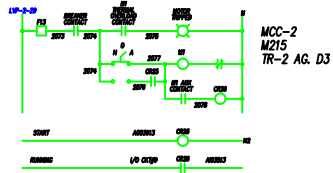


MCC-2
M215
TR-2 AG. D3

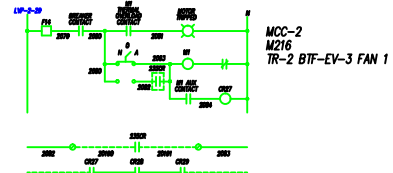


MCC-2
M216
TR-2 BIT-EV-3 FAN 1

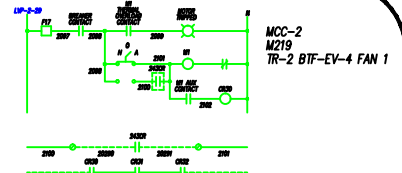


MCC-2
M219
TR-2 BIT-EV-4 FAN 1

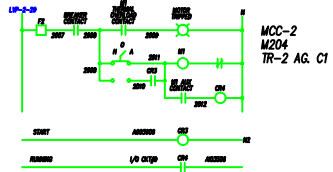


MCC-2
M204
TR-2 AG. C1

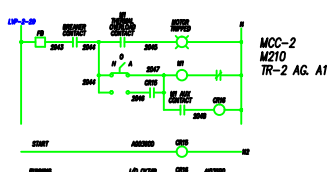


MCC-2
M210
TR-2 AG. A1

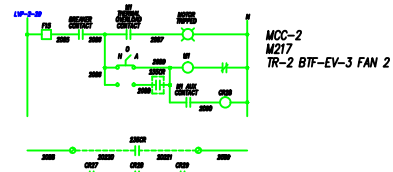


MCC-2
M217
TR-2 BIT-EV-3 FAN 2

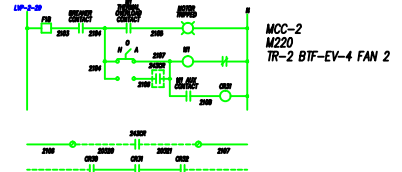


MCC-2
M220
TR-2 BIT-EV-4 FAN 2

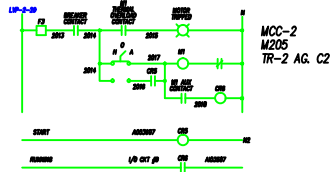


MCC-2
M205
TR-2 AG. C2

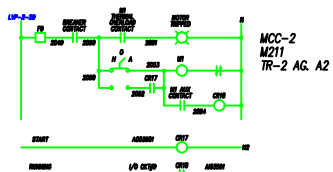


MCC-2
M211
TR-2 AG. A2

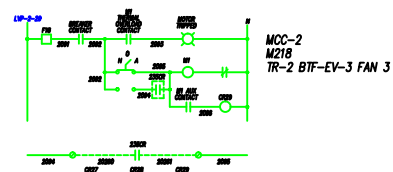


MCC-2
M218
TR-2 BIT-EV-3 FAN 3

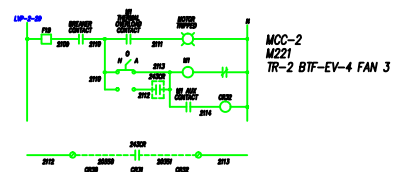


MCC-2
M221
TR-2 BIT-EV-4 FAN 3

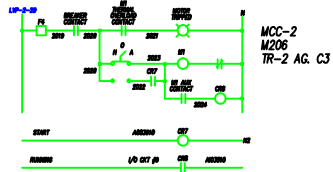


MCC-2
M206
TR-2 AG. C3

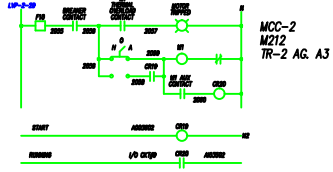


MCC-2
M212
TR-2 AG. A3

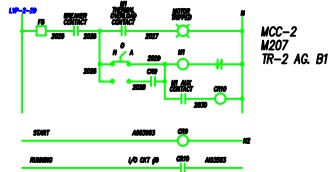


MCC-2
M207
TR-2 AG. B1

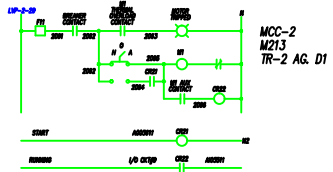

MCC-2
M213
TR-2 AG. D1

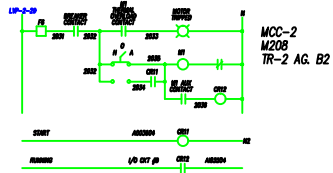

MCC-2
M208
TR-2 AG. B2

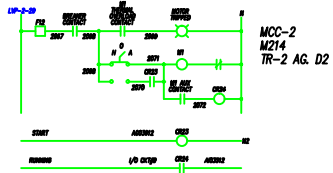


MCC-2
M214
TR-2 AG. D2

TANK ROOM #2 REFRIGERATION PENTHOUSE MOTOR CONTROL DIAGRAMS
ARCH D-SIZE SHEET SCALE: NOT TO SCALE (SCALED TO FIT)

BULK TANK ROOM #2 MOTOR CONTROL DIAGRAMS
ARCH D-SIZE SHEET SCALE: NOT TO SCALE (SCALED TO FIT)

MCC-2 MOTOR CONTROL ELEVATION
ARCH D-SIZE SHEET SCALE: NOT TO SCALE (SCALED TO FIT)

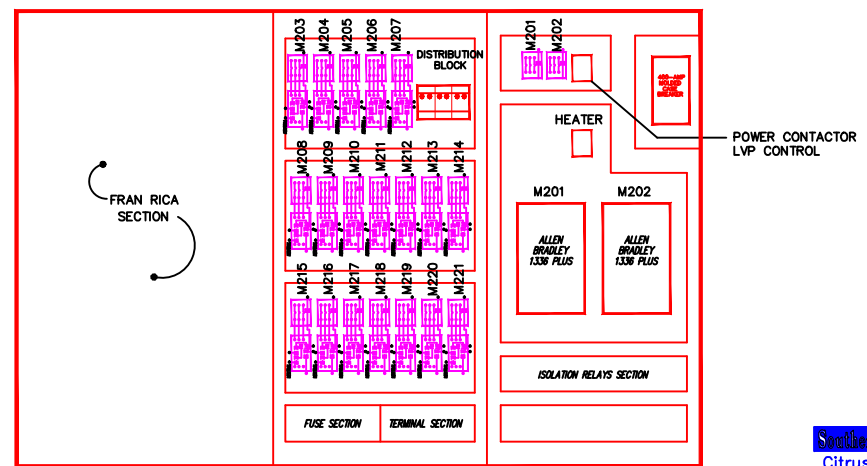

Southern Gardens
Citrus Processing
Clewiston, Florida
Bulk Storage Tank Facility
WINTER HAVEN ELECTRIC, INC.
Electrical As-Built
E-56